

Date: Monday, 7/31/2006 12:50:04 PM  
User: Kim Johnston

## **Process Sheet**

<b>Customer</b>	: CU-DAR001 Dart Helicopters Services	<b>Drawing Name</b>	: 350/212/130 BASKET LID
<b>Job Number</b>	: 28036B	<b>Part Number</b>	: D2512
<b>Estimate Number</b>	: 10193	<b>Drawing Number</b>	: D2512 REV D2
<b>P.O. Number</b>	: N/A	<b>Project Number</b>	: N/A
<b>This Issue</b>	: 7/31/2006	<b>Drawing Revision</b>	: D2
<b>Prsht Rev.</b>	: NC	<b>Material</b>	: N/A
<b>First Issue</b>	: N/A	<b>Due Date</b>	: 8/7/2006
<b>Previous Run</b>	: 27997B	<b>Qty:</b>	1
<b>Written By</b>	: <u>HJ</u>	<b>Um:</b>	Each
<b>Checked &amp; Approved By</b>	: <u>HJ</u> 06.07.31		
<b>Comment</b>	: Rev Est:M 08.01.31 Added D2012-117 for D130-701-041 KJ/ RF Est Rev:N 06.04.05 Added level21 EC		

## **Additional Product**

Job Number:



Seq. #:	Machine Or Operation:	Description :
1.0	M304TS0750W065	304 SQ Tube.75x.75x.065W 
		
	Comment: Qty.: 45.7594 f(s)/Unit Total : 45.7594 f(s)	
	Pick: 3/4"x3/4" 304/316 SS tube .063" wall Batch: <u>M101509-51 M101561</u>	 06-08-10 
2.0	D31663	Basket Hoop 
		
	Comment: Qty.: 1.0000 Each(s)/Unit Total : 1.0000 Each(s)	
	Pick: Qty Part Number Description Batch 1 D3166-3 Basket Hoop <u>B23095</u>	 06-08-15 
3.0	D2506	Placard 
		
	Comment: Qty.: 1.0000 Each(s)/Unit Total : 1.0000 Each(s)	
	Pick: Qty Part Number Description Batch 1 D2506 Label Plate <u>B26631-2</u>	 06-08-05 
4.0	D23271	Spacer Bushing 
		
	Comment: Qty.: 2.0000 Each(s)/Unit Total : 2.0000 Each(s)	
	Pick: Qty Part Number Description Batch 2 D2327-1 Bushing <u>B26742</u>	 06-08-15 

W/O:		WORK ORDER CHANGES					
DATE	STEP	PROCEDURE CHANGE	By	Date	Qty	Approval Mfg / Design Mgr	Approval QC Inspector

NCR:		WORK ORDER NON-CONFORMANCE (NCR)						
DATE	STEP	Description of NC Section A	Corrective Action Section B			Verification Section C	Approval Design Mgr	Approval QC Inspector
			Initial Design Mgr	Action Description Design Mgr	Sign & Date			

Part No: \_\_\_\_\_ PAR #: \_\_\_\_\_ Fault Category: \_\_\_\_\_ NCR: Yes No DQA: \_\_\_\_\_ Date: \_\_\_\_\_

NOTE: Date & initial all entries QA: N/C Closed: \_\_\_\_\_ Date: \_\_\_\_\_

Date: Monday, 7/31/2006 12:50:04 PM  
User: Kim Johnston

## Process Sheet

Customer: CU-DAR001 Dart Helicopters Services

Drawing Name: 350/212/130 BASKET LID

Job Number: 28036B

Part Number: D2512

Job Number:



Seq. #:	Machine Or Operation:	Description :
---------	-----------------------	---------------

5.0	D22321	Hinge
-----	--------	-------



Comment: Qty.: 2.0000 Each(s)/Unit Total : 2.0000 Each(s)

Pick:

Qty Part Number	Description	Batch
2 D2232-1	Hinge plate	B25233

PD

06-08-22

(1)

6.0	D2581	Mounting Bracket
-----	-------	------------------



Comment: Qty.: 2.0000 Each(s)/Unit Total : 2.0000 Each(s)

Pick:

Qty Part Number	Description	Batch
2 D2581	Mounting Bracket	B27524-1 B27587-1

PD

06-08-22

(1)

7.0	M304EX07516F	Expanded Metal Flat Stai
-----	--------------	--------------------------



Comment: Qty.: 18.0000 sf(s)/Unit Total : 18.0000 sf(s)

Pick:

Qty Part Number	Description	Batch
18 sf	M304EX0.75-16F Expanded Metal	M1017D7

PD

06-08-22

(1)

8.0	LARGE FAB 1	LARGE FABRICATION RESOURCE 1
-----	-------------	------------------------------



Comment: LARGE FABRICATION RESOURCE 1

1-Cut 3/4" x 3/4" square tubing as per Dwg D2512

2-Cut (4) D2236 From D3166-3

3-Drill holes in D2512-1 as per Dwg D2512 using Drill Jig DT8305

5-Weld as per Dwg D2512 using Welding Table and corner Jig Deburr as required

9.0	QC9/6	DDIMENSIONAL & WELDING INSPECTION
-----	-------	-----------------------------------



Comment: DDIMENSIONAL & WELDING INSPECTION

06-08-22 (1)

W/O:		WORK ORDER CHANGES					
DATE	STEP	PROCEDURE CHANGE	By	Date	Qty	Approval Mfg / Design Mgr	Approval QC Inspector

NCR:		WORK ORDER NON-CONFORMANCE (NCR)						
DATE	STEP	Description of NC Section A	Corrective Action Section B			Verification Section C	Approval Design Mgr	Approval QC Inspector
			Initial Design Mgr	Action Description Design Mgr	Sign & Date			

Part No: \_\_\_\_\_

PAR #: \_\_\_\_\_

Fault Category: \_\_\_\_\_

NCR: Yes

 NoDQA: 

Date: 06/08/127

NOTE: Date &amp; initial all entries

QA: N/C Closed: \_\_\_\_\_

Date: \_\_\_\_\_

Date: Monday, 7/31/2006 12:50:04 PM  
User: Kim Johnston

## Process Sheet

Customer: CU-DAR001 Dart Helicopters Services

Drawing Name: 350/212/130 BASKET LID

Job Number: 28036B

Part Number: D2512

Job Number:



Seq. #: Machine Or Operation:

Description :

10.0 POWDER COATING POWDER COATING



Comment: POWDER COATING

Powder Coat White Gloss (Ref: 4.3.5.1) as per QSI 005 4.3

DL 06/08/23

①

11.0 HAND FINISHING1 HAND FINISHING RESOURCE #1



Comment: HAND FINISHING RESOURCE #1

Wing Walk and Spray Paint black as per Dwg D2512 and QSI 005 4.4

Batch: M10626

9. m 06-08-24

②

12.0 QC3 INSPECT POWDER COAT/CHEMICAL CONVERSION



Comment: INSPECT POWDER COAT/CHEMICAL CONVERSION

mf. 06/08/24

13.0 PACKAGING 1 PACKAGING RESOURCE #1



Comment: PACKAGING RESOURCE #1

Identify and Stock

Location: GA

MF - 06/08/24

14.0 DC DOCUMENT CONTROL



Comment: DOCUMENT CONTROL

Inspection Level 21

06.08.25

Job Completion



U 06.08.25

W/O:		WORK ORDER CHANGES					
DATE	STEP	PROCEDURE CHANGE	By	Date	Qty	Approval Mfg / Design Mgr	Approval QC Inspector

NCR:		WORK ORDER NON-CONFORMANCE (NCR)						
DATE	STEP	Description of NC Section A	Corrective Action Section B			Verification Section C	Approval Design Mgr	Approval QC Inspector
			Initial Design Mgr	Action Description Design Mgr	Sign & Date			

Part No: \_\_\_\_\_ PAR #: \_\_\_\_\_ Fault Category: \_\_\_\_\_ NCR: Yes No DQA: \_\_\_\_\_ Date: \_\_\_\_\_

NOTE: Date & initial all entries QA: N/C Closed: \_\_\_\_\_ Date: \_\_\_\_\_

**DART**


DESIGN BW	DRAWN BY <i>CP</i>	DART AEROSPACE LTD HAWKESBURY, ONTARIO, CANADA	
CHECKED <i>✓</i>	APPROVED <i>✓</i>	DRAWING NO. D2512	REV. D SHEET 1 OF 4
DATE 01.04.19		TITLE BASKET LID ASSEMBLY (350/212)	SCALE NTS

**RELEASED**  
01.04.27 *CP*

A	95.11.21	NEW ISSUE
B	96.05.24	ADDED LATCH CHANNEL & LABEL PLATE
C	99.07.06	REMOVE DOUBLE SKIN SECTION, ADDED MEMBERS, INCORP. DEO 9074
D	01.04.19	CHANGE HINGE
D1	<del>CP</del> 03.01.20	ADD D2012-117 FOR D130-701-041
D2	<del>CP</del> 04.09.20	TACK WELD ANTI-SKID AREA

PARTS LIST FOR D2512 BASKET LID ASSEMBLY

PART NO	QUANTITY	LENGTH A	LENGTH B	DESCRIPTION
D2512-1	2	—	25.50	RIB
D2512-3	2	—	95.30	RIB
D2512-5	6	30.84	—	RIB
D2512-7	3	30.63	—	RIB
D2232-1	2	N/A	N/A	HINGE PLATE
D2236	4	N/A	N/A	RIB
D2327-1	2	N/A	N/A	BUSHING
D2506	1	N/A	N/A	LABEL PLATE
D2581	2	N/A	N/A	MOUNTING BRKT

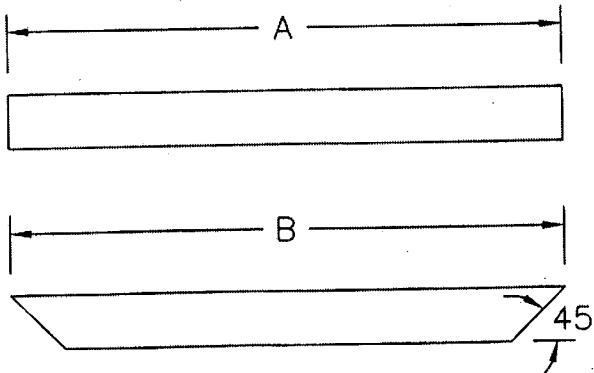D2512-1/-3/-5/-7

CUT LENGTH/SHAPE PER DIAGRAM AND PARTS LIST

MATERIAL: AISI 304/316 SS, 3/4 X 3/4 X 0.060 WALL SQUARE TUBING

TOLERANCES ARE PER DART QSI 018 UNLESS OTHERWISE NOTED

ALL DIMENSIONS ARE IN INCHES

SHOP COPY  
RETURN TO  
ENGINEERING  
UNCONTROLLED COPY  
SUBJECT TO AMENDMENT  
WITHOUT NOTICE  
WORK ORDER  
NO. 28036 B


THIS DOCUMENT IS PRIVATE AND CONFIDENTIAL AND IS SUPPLIED ON THE EXPRESS CONDITION THAT IT IS NOT TO BE USED FOR ANY PURPOSE OR COPIED OR COMMUNICATED TO ANY OTHER PERSON WITHOUT WRITTEN PERMISSION FROM DART AEROSPACE LTD.

Copyright © 1995 by DART

AEROSPACE LTD

RELEASED  
FOR CONTRACTOR USE  
ONLY  
NO. \_\_\_\_\_  
WORK ORDER  
COPY  
ENGINEERING  
RETURN TO  
SHOP COPY

D2

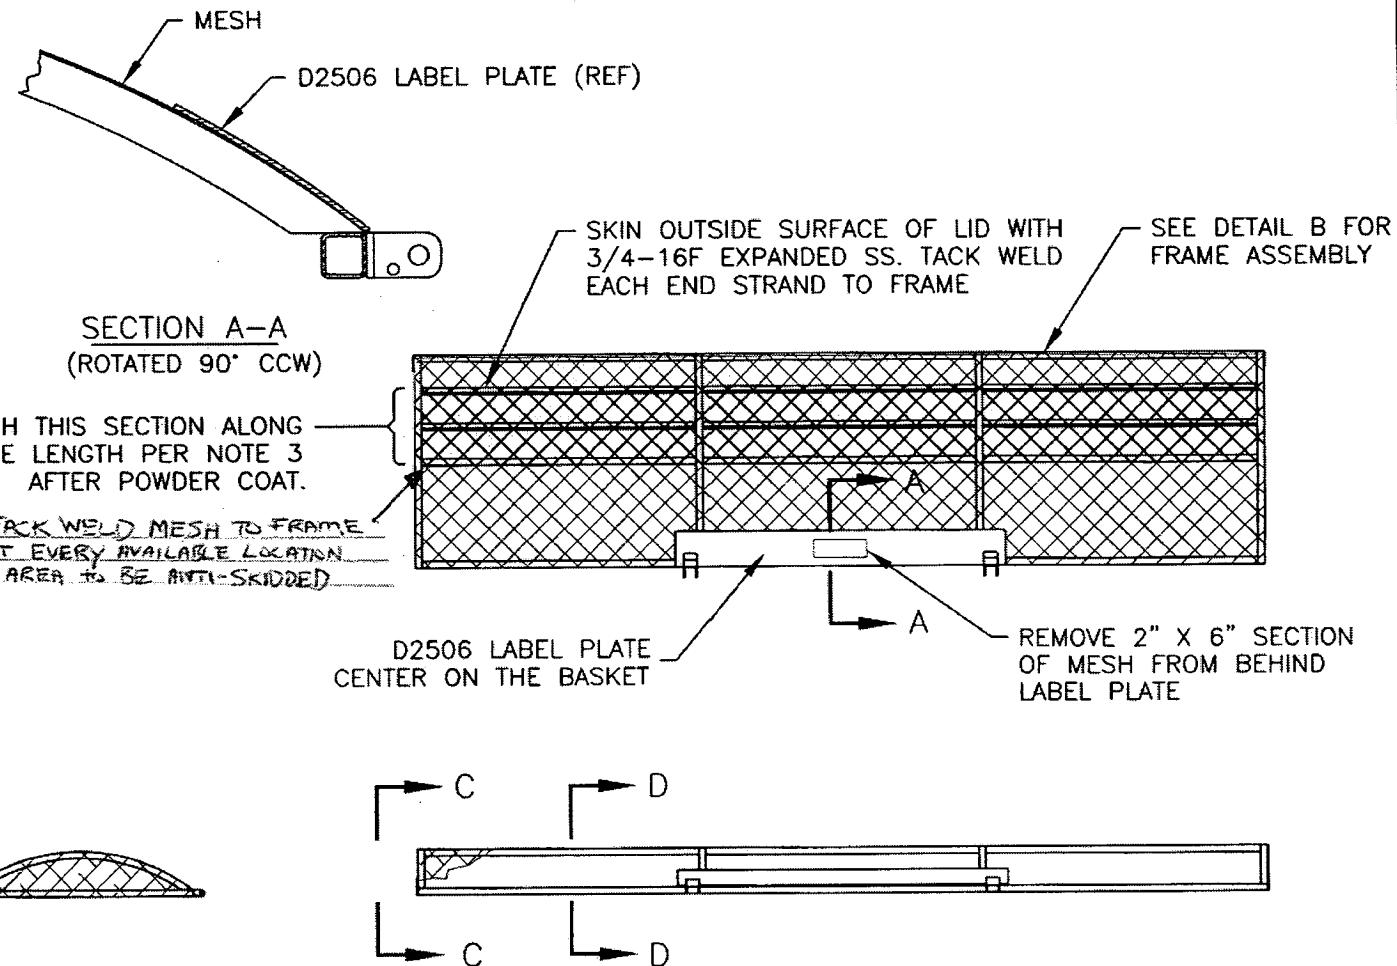

D2512 BASKET LID ASSEMBLY

- 1) MESH MATERIAL: 3/4-16F EXPANDED SS
- 2) FINISH: POWDER COAT ENTIRE ASSEMBLY WHITE (4.3.5.2) PER DART QSI 005 4.3
- 3) SPRAY PAINT BLACK INSIDE SURFACE  
APPLY BLACK ANTI-SKID TO OUTSIDE SURFACE PER DART QSI 005 4.4
- 4) TOLERANCES ARE PER DART QSI 018 UNLESS OTHERWISE NOTED
- 5) ALL DIMENSIONS ARE IN INCHES


**DART**

DA COPY  
CENSUS

DESIGN BW	DRAWN BY <i>[Signature]</i>	DART AEROSPACE LTD
CHECKED <input checked="" type="checkbox"/>	APPROVED <input checked="" type="checkbox"/>	HAWKESBURY, ONTARIO, CANADA
DATE 01.04.19	DRAWING NO. D2512	REV. D
TITLE BASKET LID ASSEMBLY (350/212)	SHEET 2 OF 4	SCALE 1:20

**DART**

DESIGN B/W	DRAWN BY <i>JP</i>	DART AEROSPACE LTD HAWKESBURY, ONTARIO, CANADA
CHECKED <i>J</i>	APPROVED <i>J</i>	DRAWING NO. D2512
DATE 01.04.19	TITLE BASKET LID ASSEMBLY (350/212)	REV. D SHEET 3 OF 4 SCALE 1:20

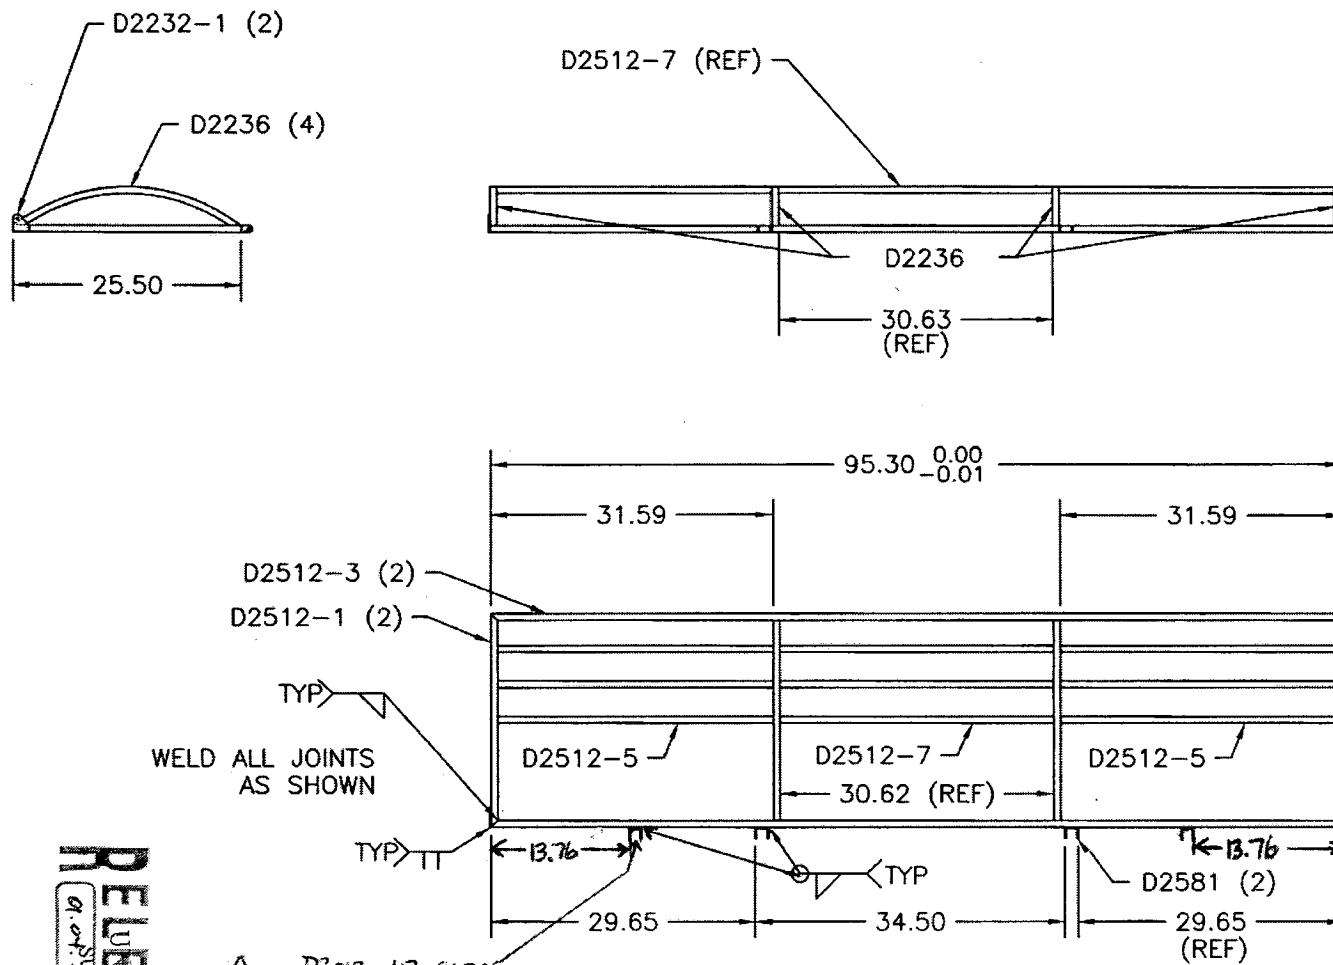


NO. \_\_\_\_\_

**RELEASED**  
 04/04/2019  
 SUBJECT TO AN ENDMENT  
 WITHOUT NOTICE  
**RE** RELEASED COPY  
 RETURN TO  
 ENGINEERING  
 04/04/2019  
 NO. \_\_\_\_\_


THIS DOCUMENT IS PRIVATE AND CONFIDENTIAL AND IS SUPPLIED ON THE EXPRESS CONDITION THAT IT IS NOT TO BE USED FOR ANY PURPOSE OR COPIED OR COMMUNICATED TO ANY OTHER PERSON WITHOUT WRITTEN PERMISSION FROM DART AEROSPACE LTD.

 Copyright © 1995 by DART AEROSPACE LTD




**DART**


DESIGN BW	DRAWN BY <i>UP</i>	DART AEROSPACE LTD HAWKESBURY, ONTARIO, CANADA	
CHECKED <i>#</i>	APPROVED <i>#</i>	DRAWING NO. D2512	REV. D SHEET 4 OF 4
DATE 01.04.19		TITLE BASKET LID ASSEMBLY (350/212)	SCALE 1:8

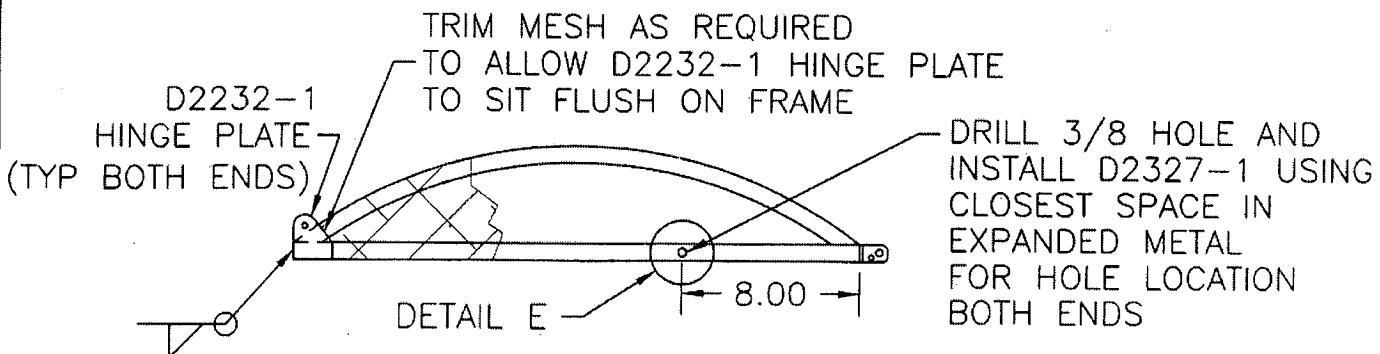

SECTION C-C SIMILAR BOTH END RIBS

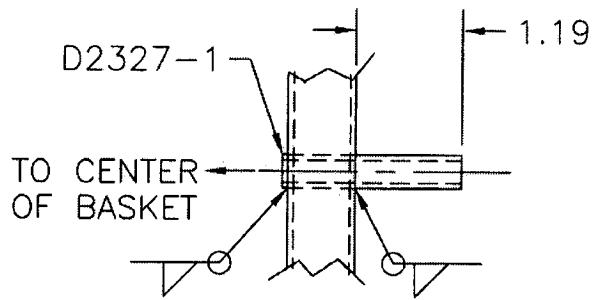

DETAIL E

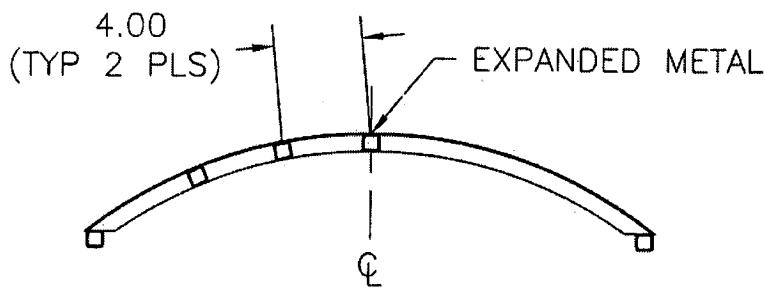

SECTION D-D SAME BOTH CENTER RIBS

RE-RELEASED  
SUBJ: 125-11  
NO. \_\_\_\_\_

SHOP COPY  
RETURN TO  
ENGINEERING  
IN COPIED COPY  
SUBJECT TO AMENDMENT  
WITHOUT NOTICE  
WORK ORDER

